

Project
39 BOURDILLON

NG-Lagos-IKOYI

Owner

LEGEND

Date	Description
02/11/2023	
08/11/2023	
10/11/2023	
11/11/2023	
13/11/2023	
18/11/2023	
05/11/2024	
09/11/2024	
11/11/2024	
20/11/2024	

For Approval


Project No. : ##-##-##
 Scale : A3 = ##
 Drawn by : P.Ibe
 Checked : Samir Bardar
 Cad File : CAD File

Sheet title
KITCHEN TYPE-T2-PLAN
 Shop Drawing

L1-L11&L16-L19

Dwg No.
WS-DS-SD-EL-006


No.
10

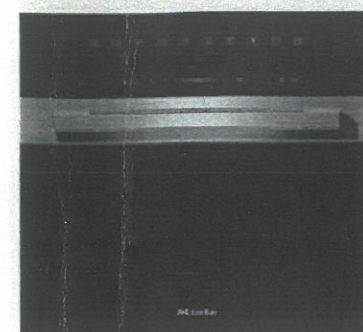

MICROWAVE OVEN

Model No. M 7240 TC - CleanSteel/Stainless Steel

Dimensions
 Niche width: 582-588 mm Niche depth: 550 mm Niche height: 450-452 mm

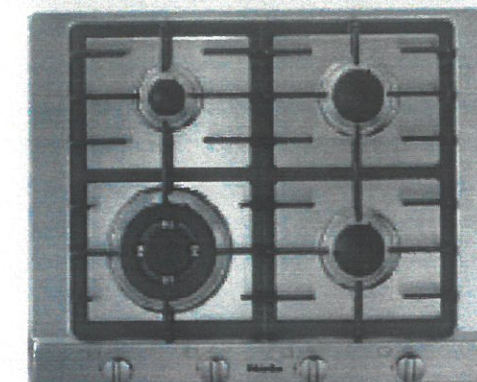

GAS HOB

MODEL NO. KM 2012-STAINLESS STEEL 20201250 I

Dimensions
 Cut-out width: 560-561 mm Cut-out depth: 480-490 mm Width: 650 mm
 Depth: 520 mm



FULLY INTEGRATED DISHWASHER

Model No. G 5050 SCVi Active 21426361 GB


Dimensions
 Width: 598 mm Depth: 570 mm Height: 805-870 mm



COMBISET INDUCTION HOB

MODEL NO. CS 1212-14-STAINLESS STEEL 27121252GB

Dimensions
 Cut-out width: 272-273 mm Cut-out depth: 500-501 mm Casing height: 73 mm
 Width: 288 mm
 Depth: 520 mm
 Height: 57 mm

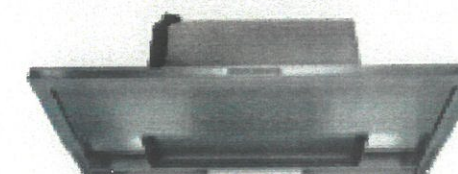


SLIMLINE COOKER HOOD


Model No. DAS 2920 - Stainless Steel
 28349655 D
 Dimensions
 Width: 896 mm
 Depth of cooker hood body: 273 mm
 Height: 36 mm



90CM OVEN

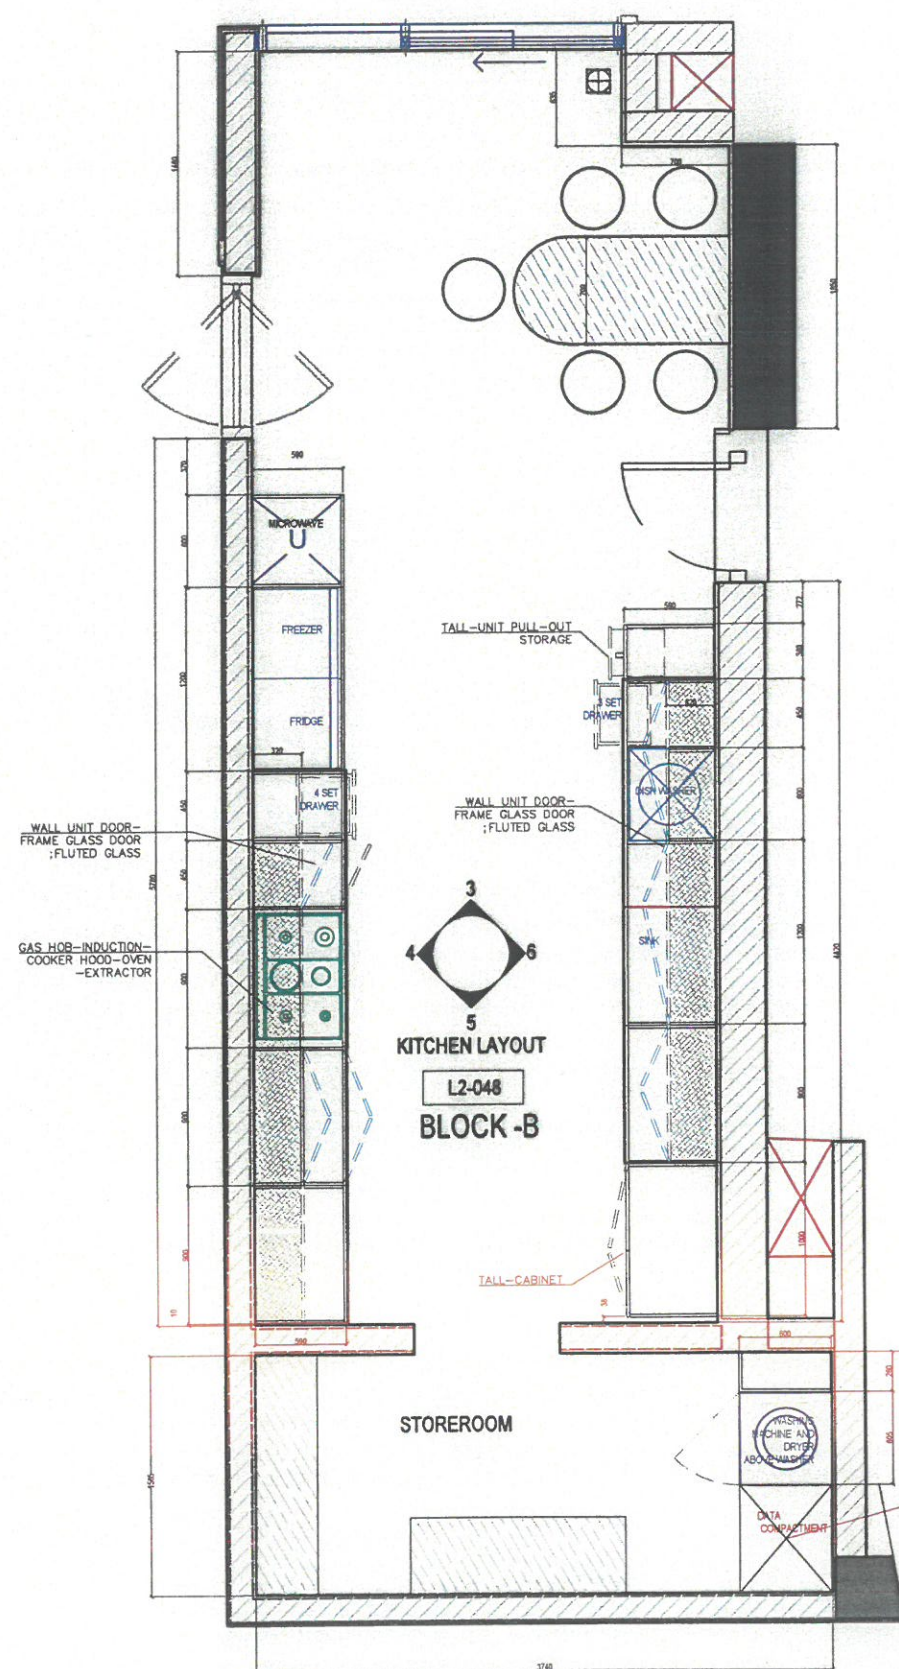


CLIENT SUGGEST TO HAVE
 WASHING MACHINE
 AND DRYER
 ABOVE EACH OTHER DUE
 TO DATA BOX MOUNTED BESIDE

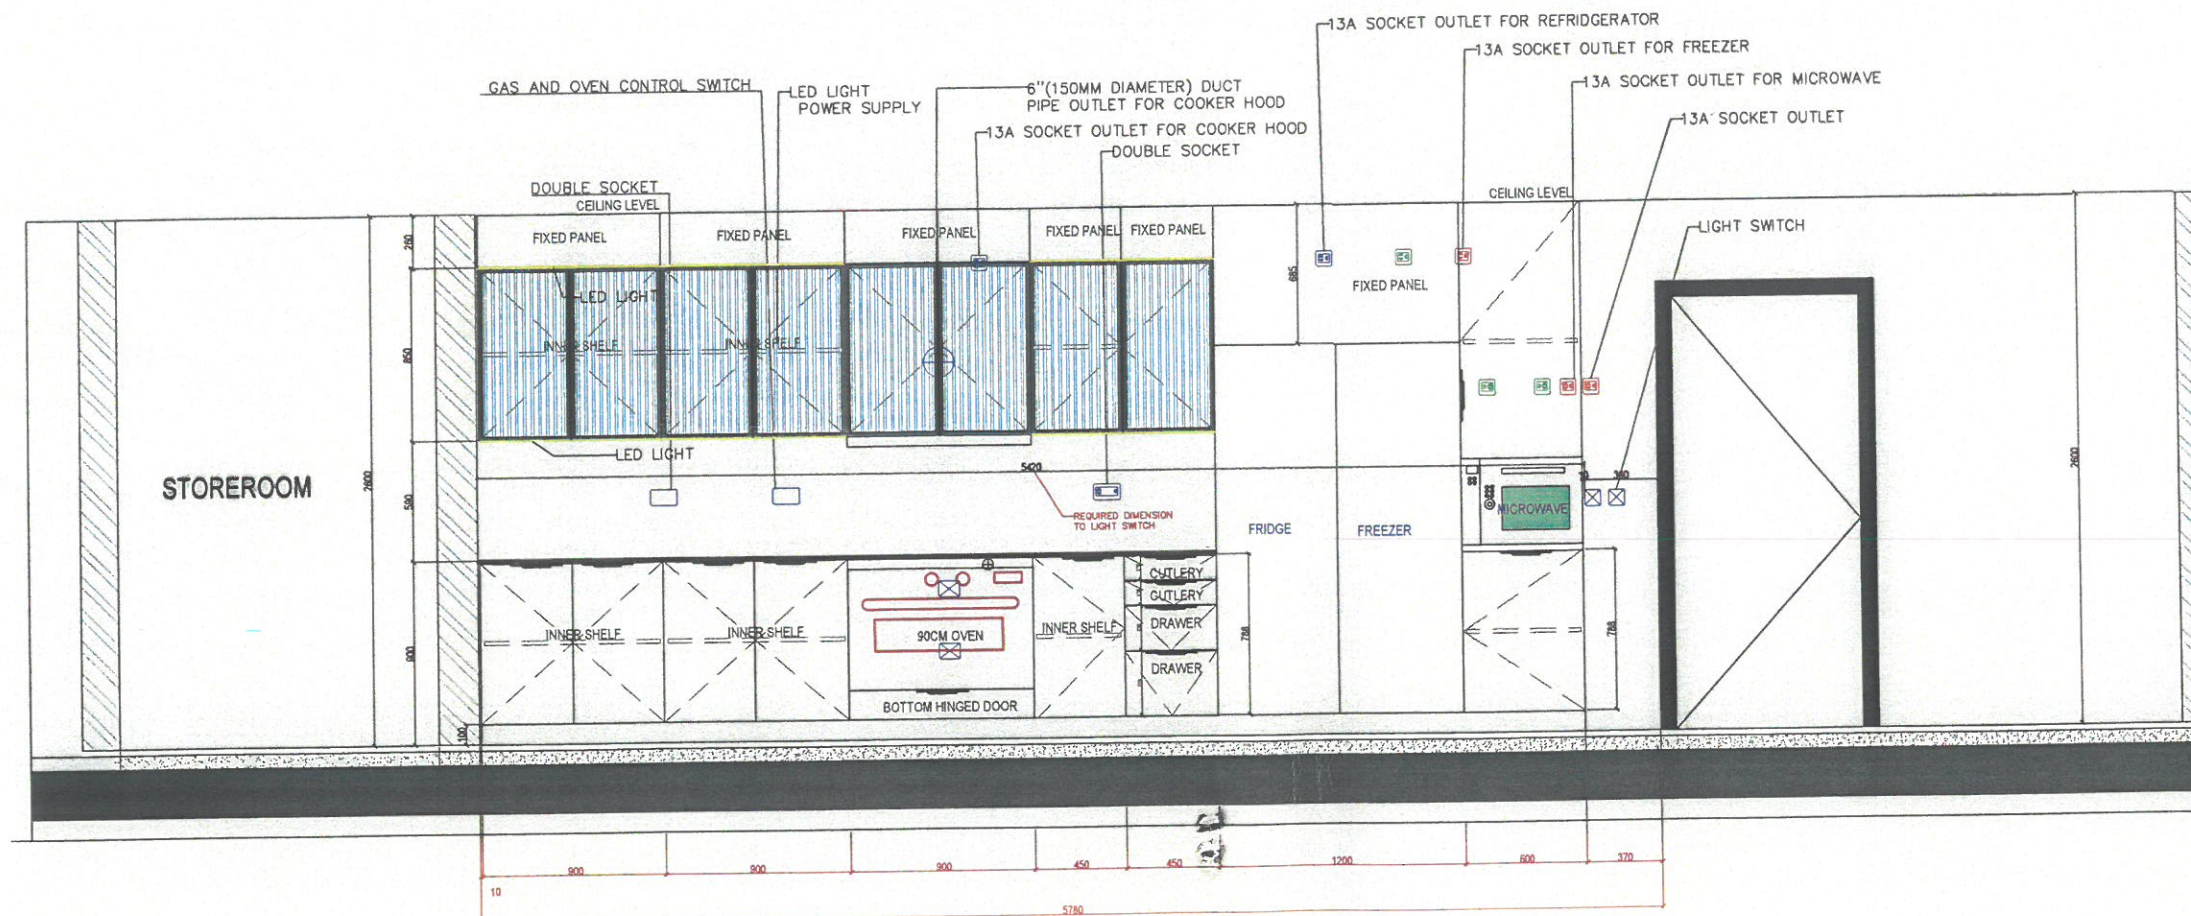

ELEVATION-04
BLOCK-B

LEGEND

- EXISTING POSITION
- EXISTING POSITION ; TO BE CHANGED
- NEW SOCKET POSITION

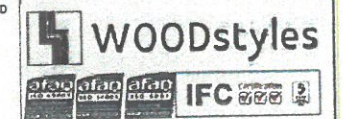

www.wood-styles.com

Copyright of designs shown herein is retained by this office.
Authority is required for any reproduction.
© Copyright Wood-styles Ltd.

Nigeria, Lagos +234 80 9037 9888
Email: info@wood-styles.com

Project
39 BOURDILLON
NG-Lagos-IKOYI

Owner

LEGEND

Date	Description
02/11/2023	
08/11/2023	
10/11/2023	
11/11/2023	
13/11/2023	
18/11/2023	
05/11/2024	
09/11/2024	
11/11/2024	
20/11/2024	

For Approval

Project No. : ##-##-##
Scale : A3 = ##
Drawn by : P.lbe
Checked : Samir Bardar
Cad File : CAD File


Sheet title
KITCHEN TYPE-T2-ELEV-04
Shop Drawing

L1-L11&L16-L19

Dwg No.
WS-DS-SD-EL-006

No.
10

- LEGEND**
- EXISTING POSITION
 - EXISTING POSITION ; TO BE CHANGED
 - NEW SOCKET POSITION

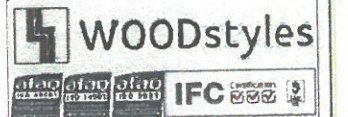

www.wood-styles.com

Copyright of designs shown herein is retained by this office.
 Authority is required for any reproduction.
 © Copyright Wood-styles Ltd.

Nigeria, Lagos +234 80 9037 9888
 Email: info@wood-styles.com

Project
39 BOURDILLON
NG-Lagos-IKOYI

Owner

LEGEND

Date	Description
02/11/2023	
08/11/2023	
10/11/2023	
11/11/2023	
13/11/2023	
18/11/2023	
05/11/2024	
10/11/2024	
09/11/2024	
11/11/2024	
20/11/2024	

For Approval


Project No. : ##-###-###
 Scale : A3 = ###
 Drawn by : P.lbe
 Checked : Samir Bardar
 Cad File : CAD File

Sheet title
KITCHEN TYPE-T2-ELEV-06
Shop Drawing


L1-L11&L16-L19

Dwg No.
WS-DS-SD-EL-006


No.
10

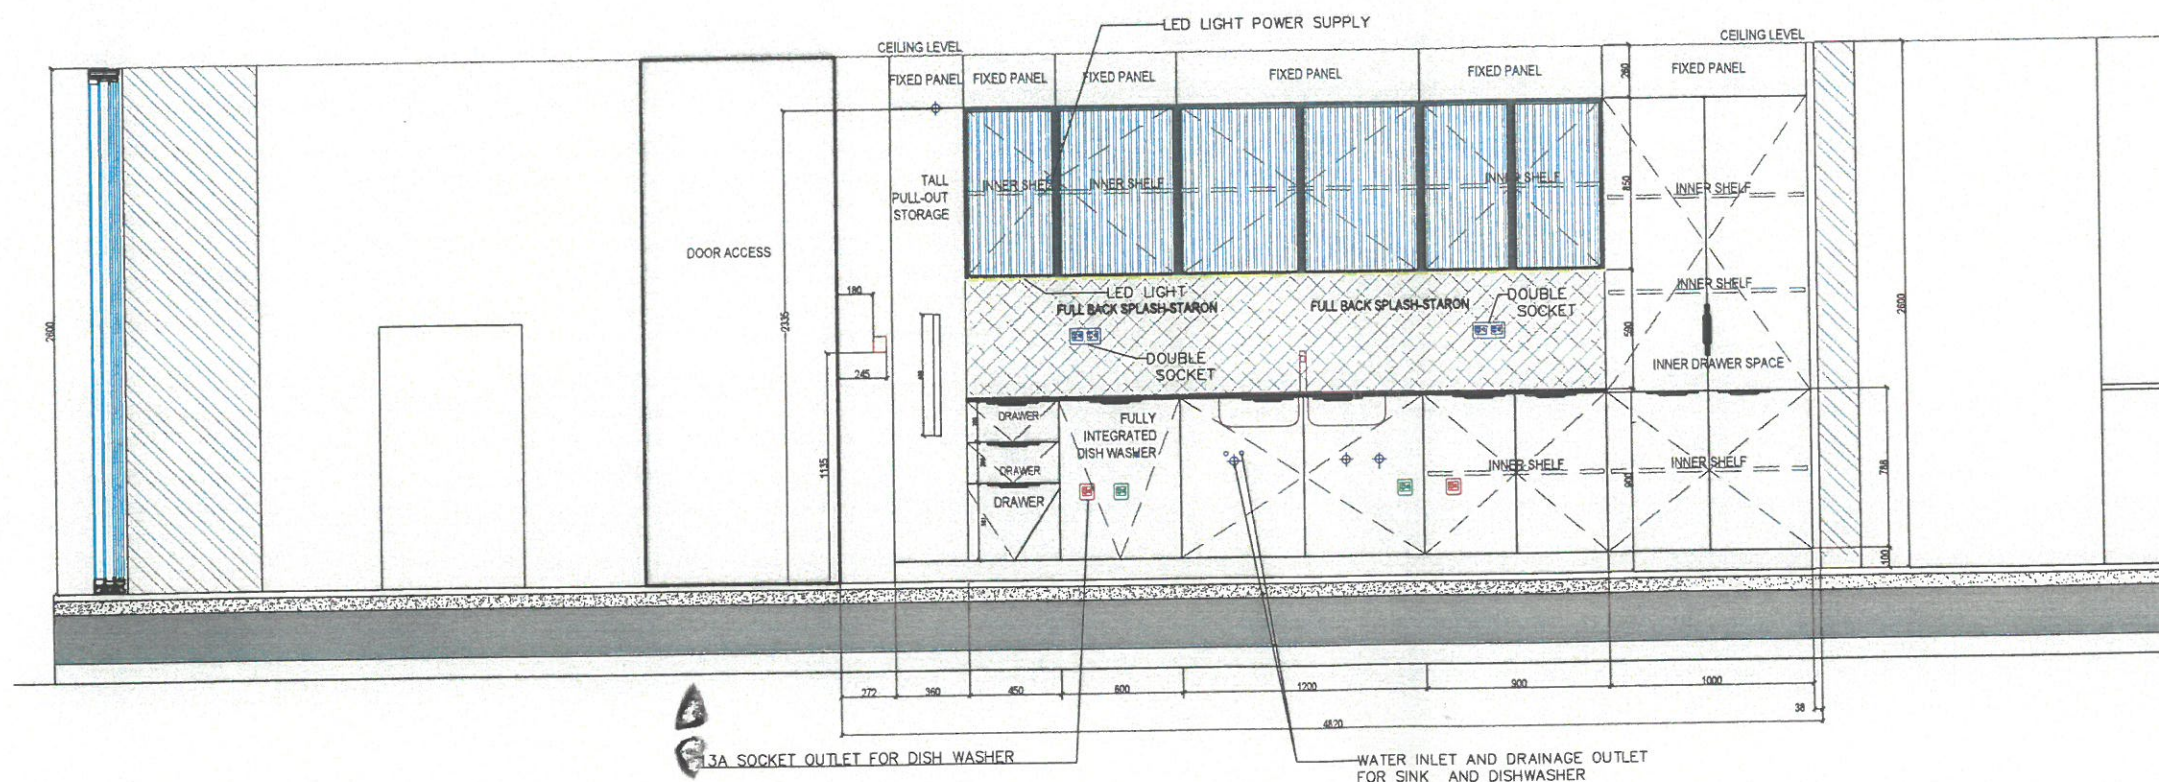

ELEVATION-06
BLOCK-B

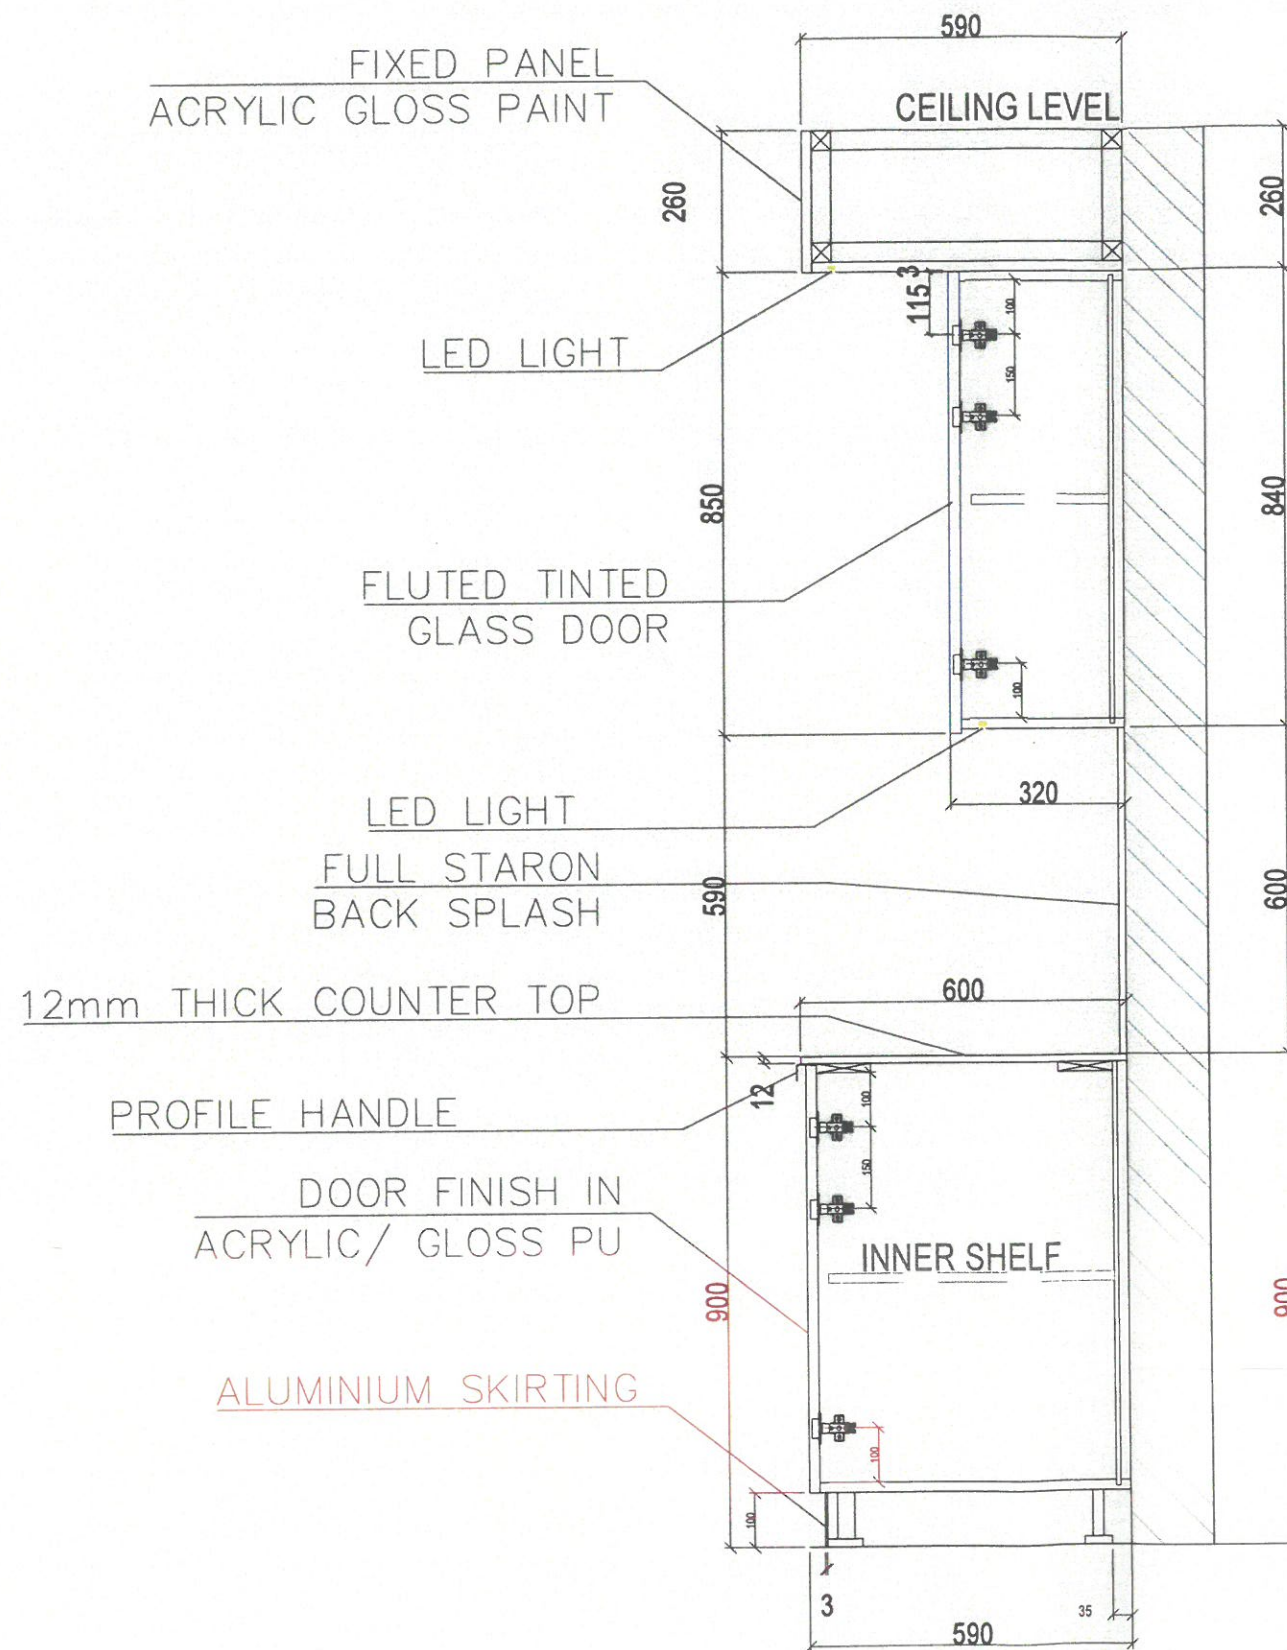

SECTION-04-06

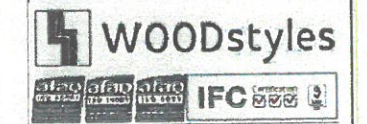

www.wood-styles.com

Copyright of designs shown herein is retained by this office.
Authority is required for any reproduction.
© Copyright Wood-styles Ltd.

Nigeria, Lagos +234 80 9037 9888
Email: info@wood-styles.com

Project
39 BOURDILLON
NG-Lagos-IKOYI
Owner

LEGEND

Date	Description
02/11/2023	
08/11/2023	
10/11/2023	
11/11/2023	
13/11/2023	
18/11/2023	
05/11/2024	
09/11/2024	
11/11/2024	
20/11/2024	

For Approval

Project No. : ##-##-##
Scale : A3 = ##
Drawn by : P.lbe
Checked : Samir Barder
Cad File : CAD File


Sheet title
KITCHEN TYPE-T2-ELEV-04
Shop Drawing

L1-L11&L16-L19

Dwg No. WS-DS-SD-EL-006 No. 10

LEGEND

- EXISTING POSITION
- EXISTING POSITION, TO BE CHANGED
- NEW SOCKET POSITION

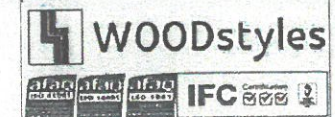

www.wood-styles.com

Copyright of designs shown herein is retained by this office.
Authority is required for any reproduction.
© Copyright Wood-styles Ltd.

Nigeria, Lagos +234 80 9037 9888

Email: info@wood-styles.com

Project

39 BOURDILLON

NG-Lagos-IKOYI

Owner

LEGEND

Date	Description
02/11/2023	
08/11/2023	
10/11/2023	
11/11/2023	
13/11/2023	
18/11/2023	
05/11/2024	
09/11/2024	
11/11/2024	
20/11/2024	


For Approval

Project No. : ##-###-###
Scale : A3 = ###
Drawn by : P.lbe
Checked : Samir Bardar
Cad File : CAD File

Sheet title
KITCHEN TYPE-T2-ELEV-04
Shop Drawing
L1-L11&L16-L19

Dwg No. WS-DS-SD-EL-006

No. 10

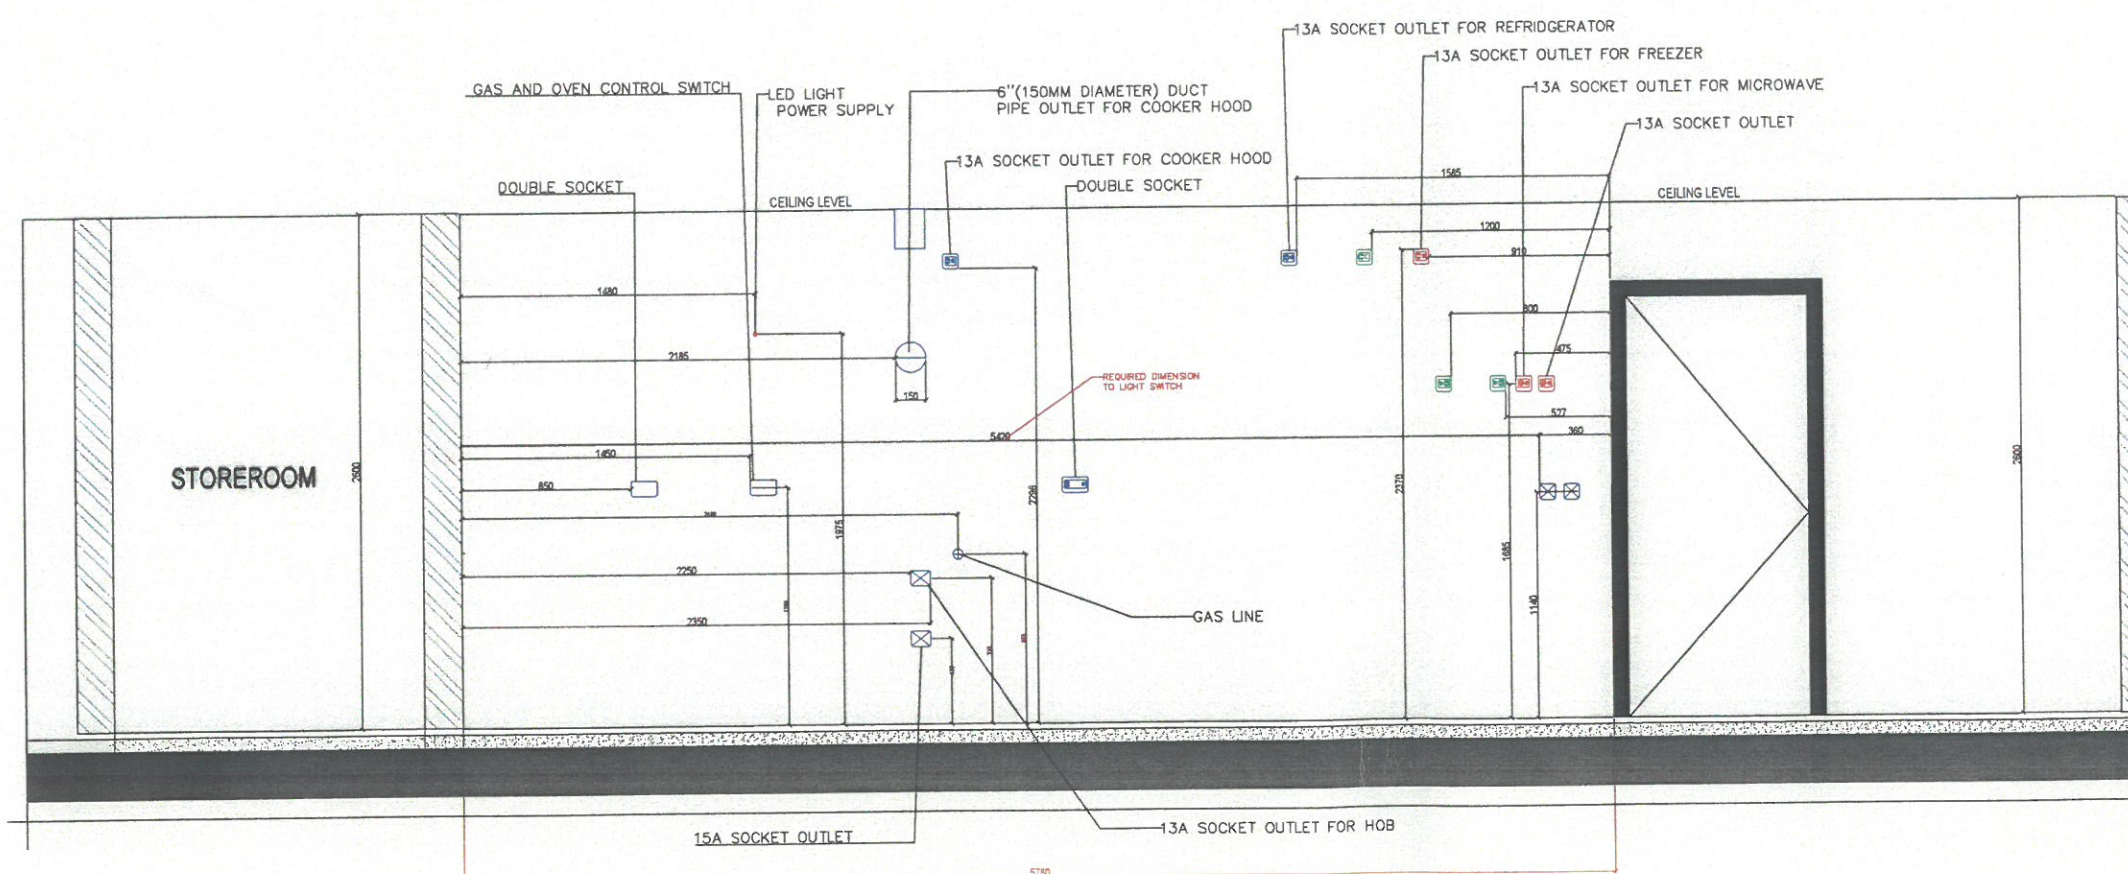

ELEVATION-04-AS BUILT WALL FIX
BLOCK -B

- LEGEND**
- EXISTING POSITION
 - EXISTING POSITION : TO BE CHANGED
 - NEW SOCKET POSITION



www.wood-styles.com

Copyright of designs shown herein is retained by this office.
 Authority is required for any reproduction.
 © Copyright Wood-styles Ltd.

Nigeria, Lagos +234 80 9037 9888
 Email: info@wood-styles.com

Project

39 BOURDILLON

NG-Lagos-IKOYI

Owner

LEGEND

Date	Description
02/11/2023	
08/11/2023	
10/11/2023	
11/11/2023	
13/11/2023	
18/11/2023	
05/11/2024	
09/11/2024	
11/11/2024	
20/11/2024	

For Approval


Project No. : ##-##-##
 Scale : A3 = ##
 Drawn by : P.lbe
 Checked : Samir Bader
 Cad File : CAD File

Sheet title
 KITCHEN TYPE-T2-ELEV-06
 Shop Drawing

L1-L11&L16-L19

Dwg No.
 WS-DS-SD-EL-006

No.
 10

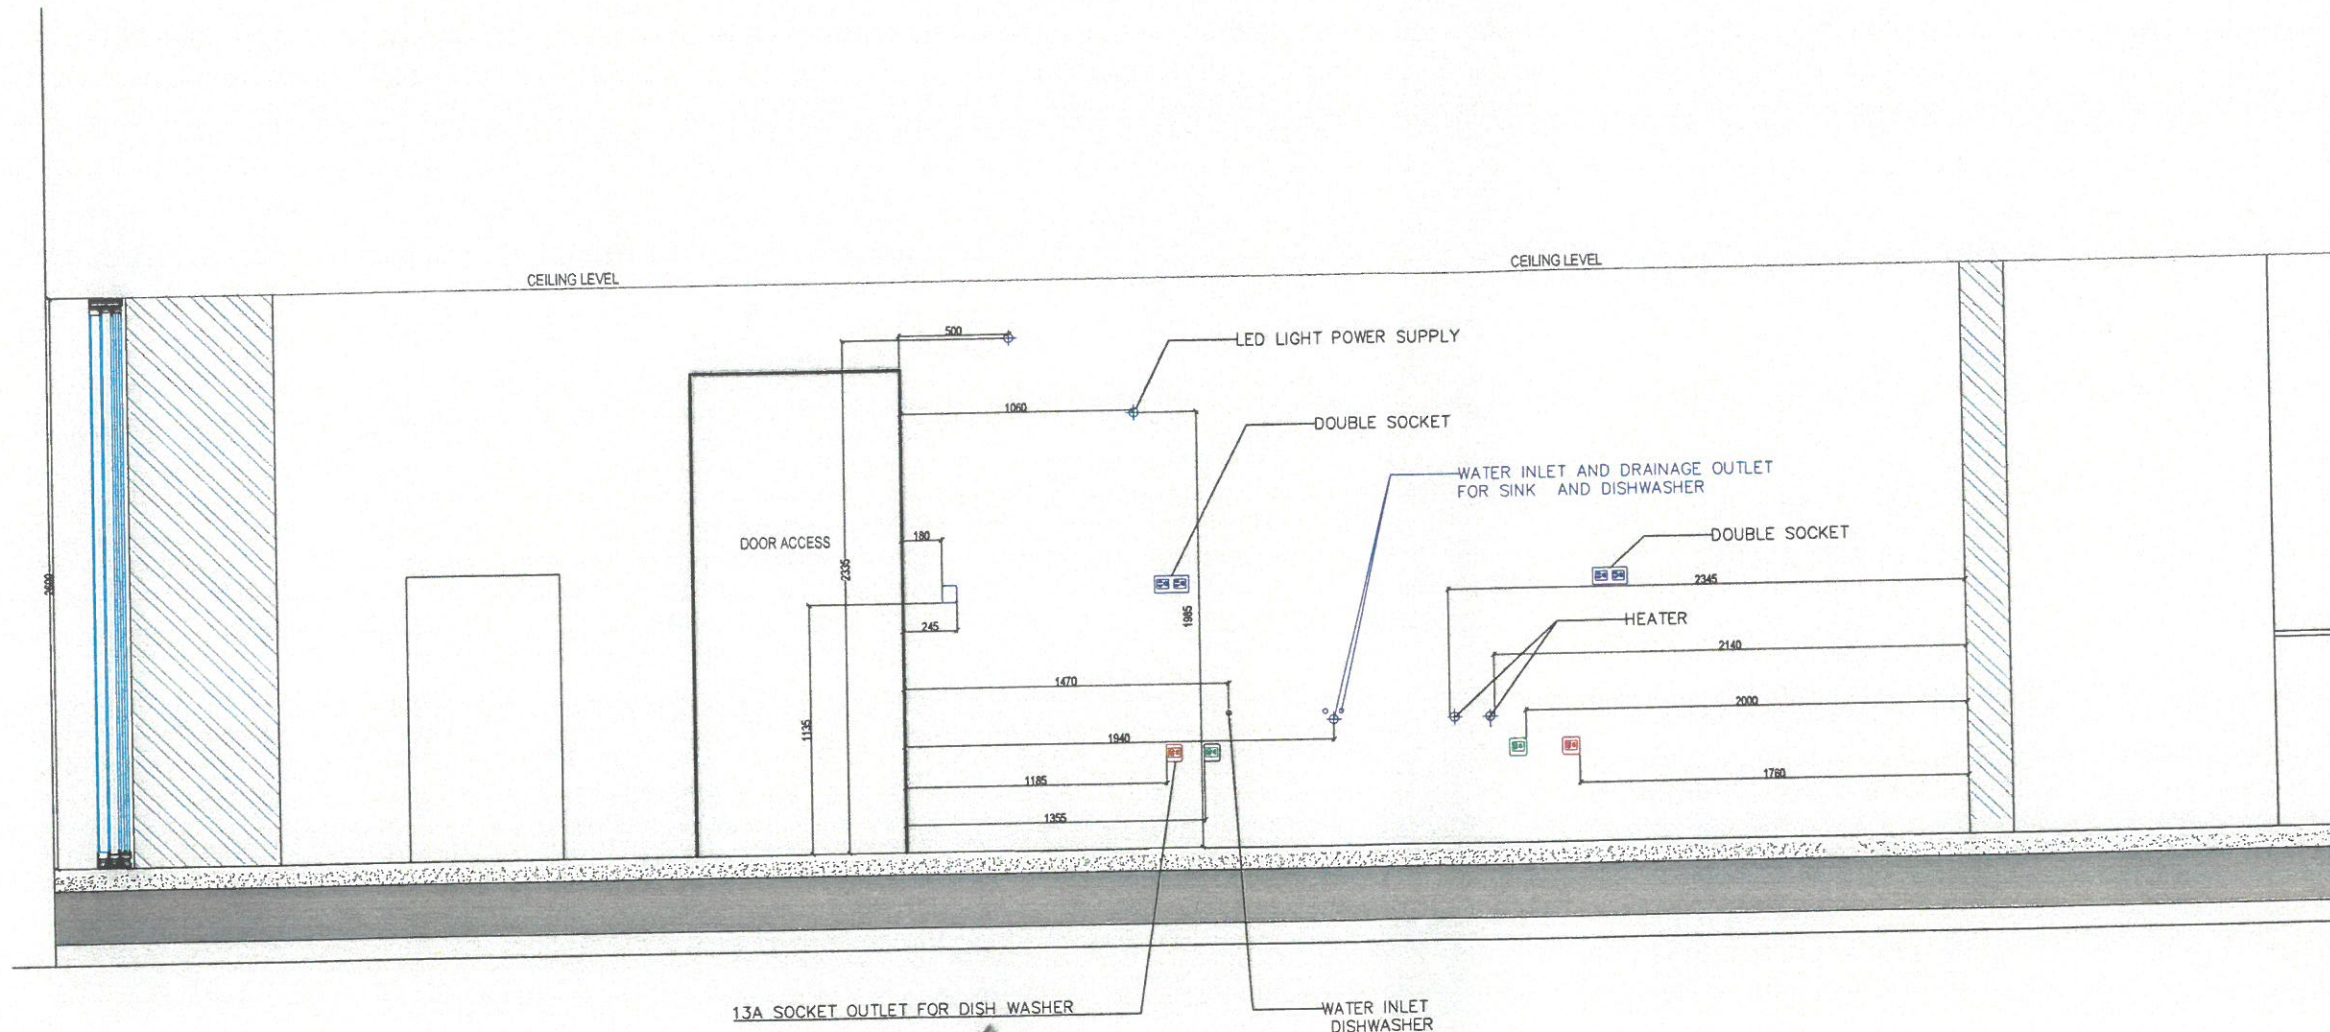

ELEVATION-06-AS BUILT WALL FIX
BLOCK -B