

Project
**MAI SHAYI CAFE
ABUJA.**

Owner
—


Date	Description
DSD-V1-ID-30/4/2024 - REV1	
DSD-V1-ID-11/7/2024 - REV2	

FOR APPROVAL

Project No. : —
Scale : N/A
Drawn by : OBJ
Checked : OBJ
Cad File : CAD_FILE



Sheet title
**GROUND FLOOR
MAI SHAYI CAFE
MAIN INDOOR BAR
WITH WOODEN PANEL AND SLATS
Elevation-B**

Dwg No. WS-DS-SD-MS-005	No. SHEET 3
----------------------------	----------------

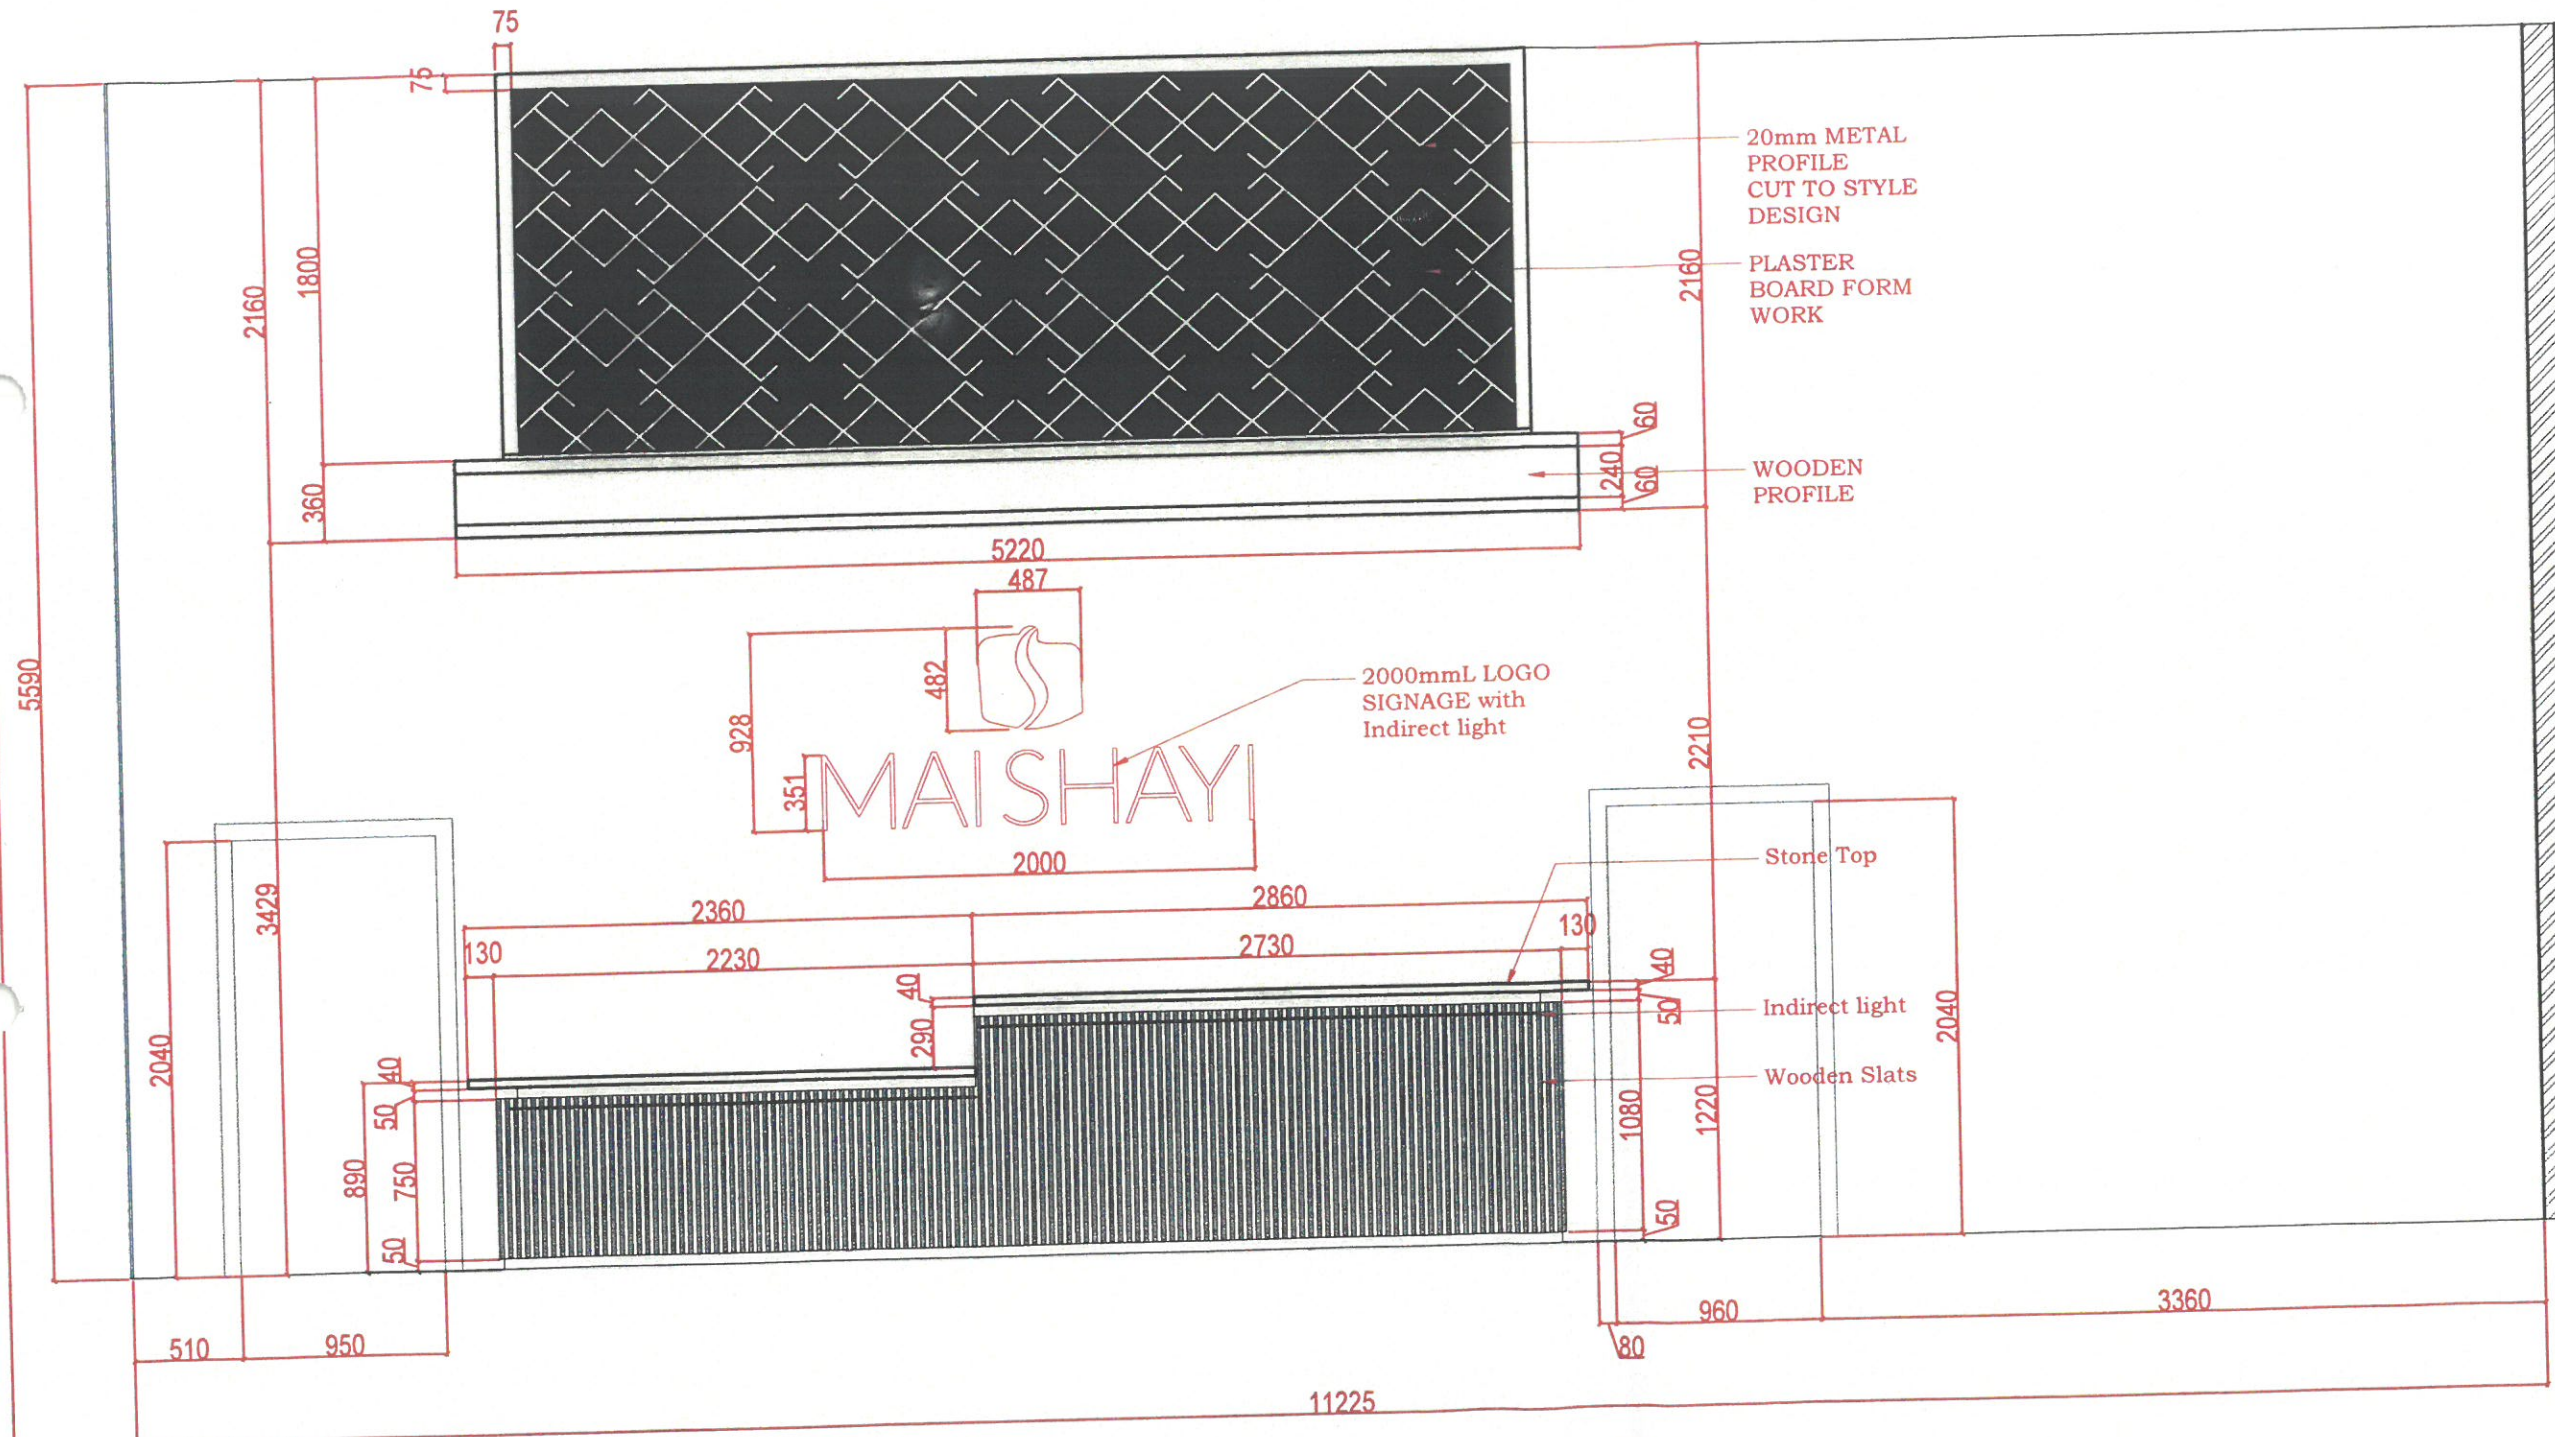

Elevation - B

11225

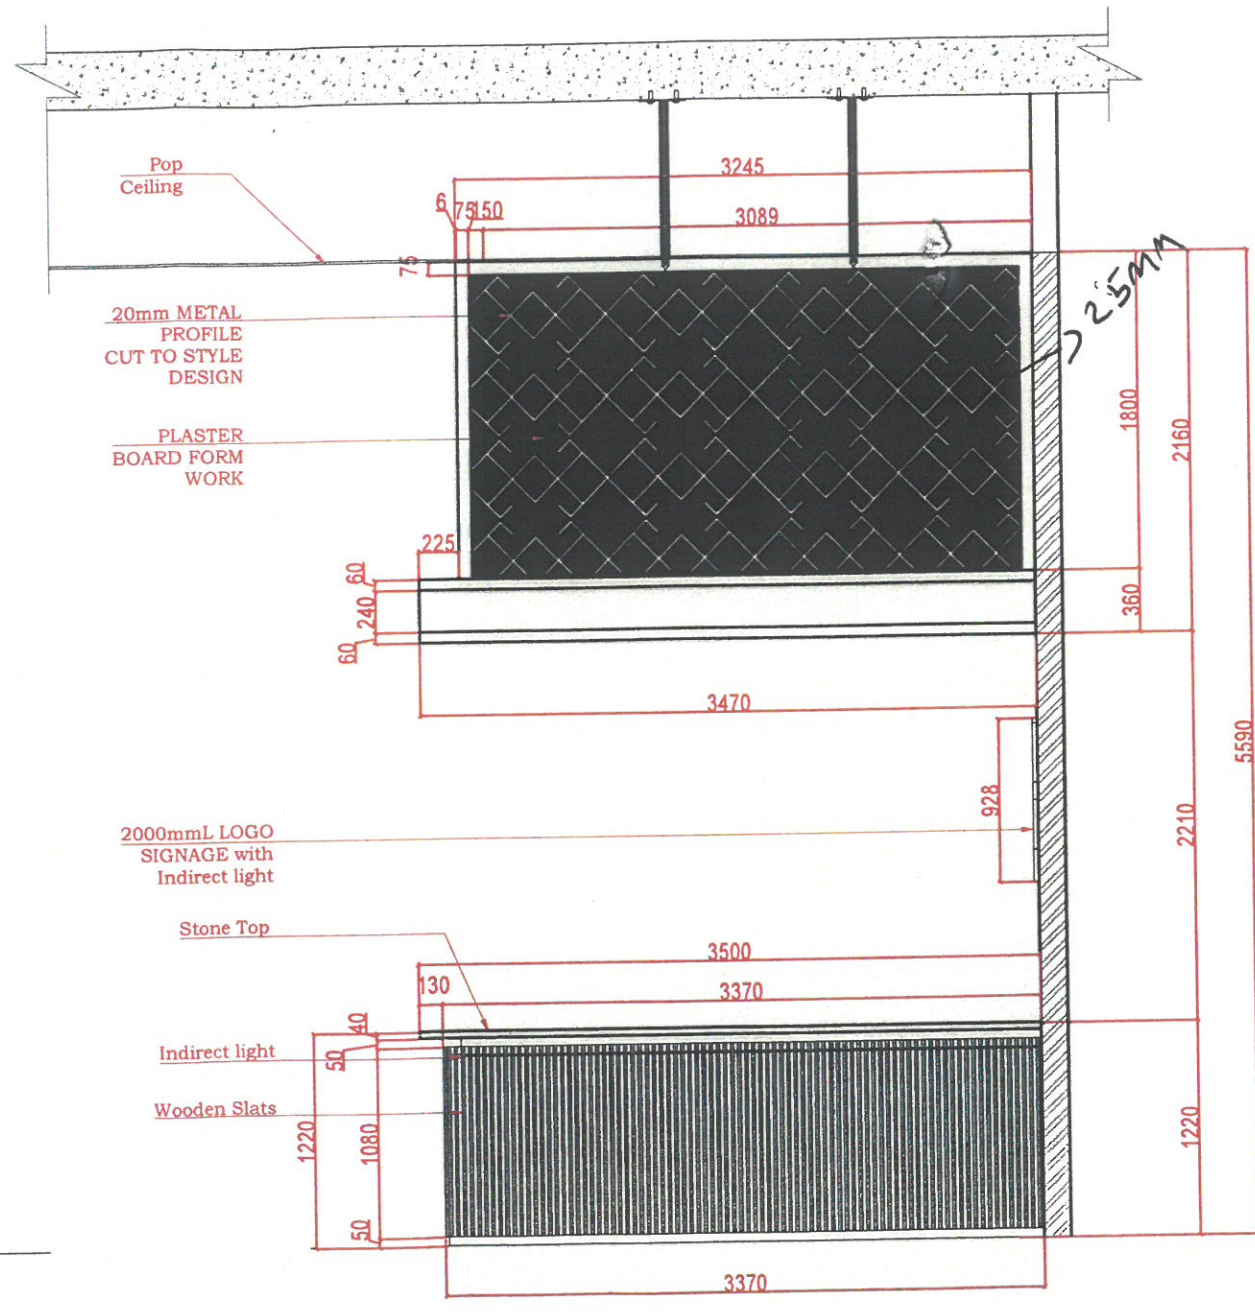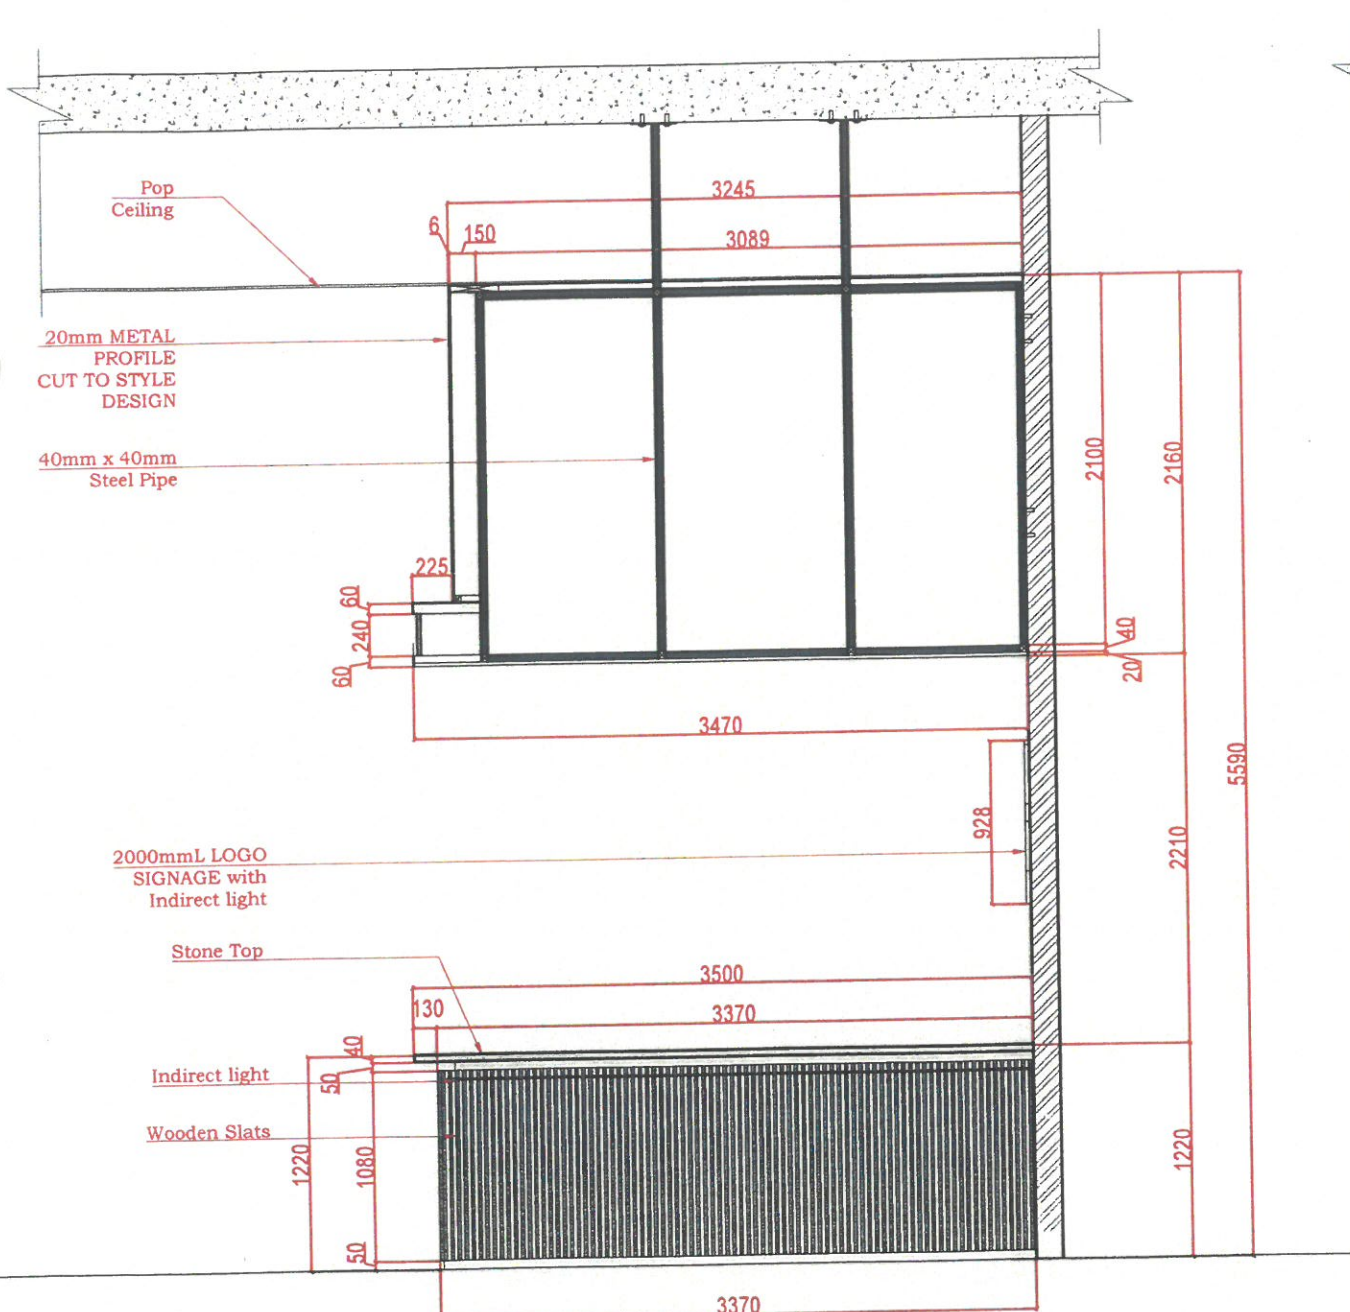

Elevation - C

FOR APPROVAL

Project No. : —
Scale : N/A
Drawn by : OBJ
Checked : OBJ
Cad File : CAD_FILE


Sheet title
**GROUND FLOOR
MAI SHAYI CAFE
MAIN INDOOR BAR
WITH WOODEN PANEL AND SLATS
Elevation-B**

Dwg No. WS-DS-SD-MS-005	No. SHEET 4
-----------------------------------	-----------------------

00
00

Mai Srayi → Bulk Head

4458

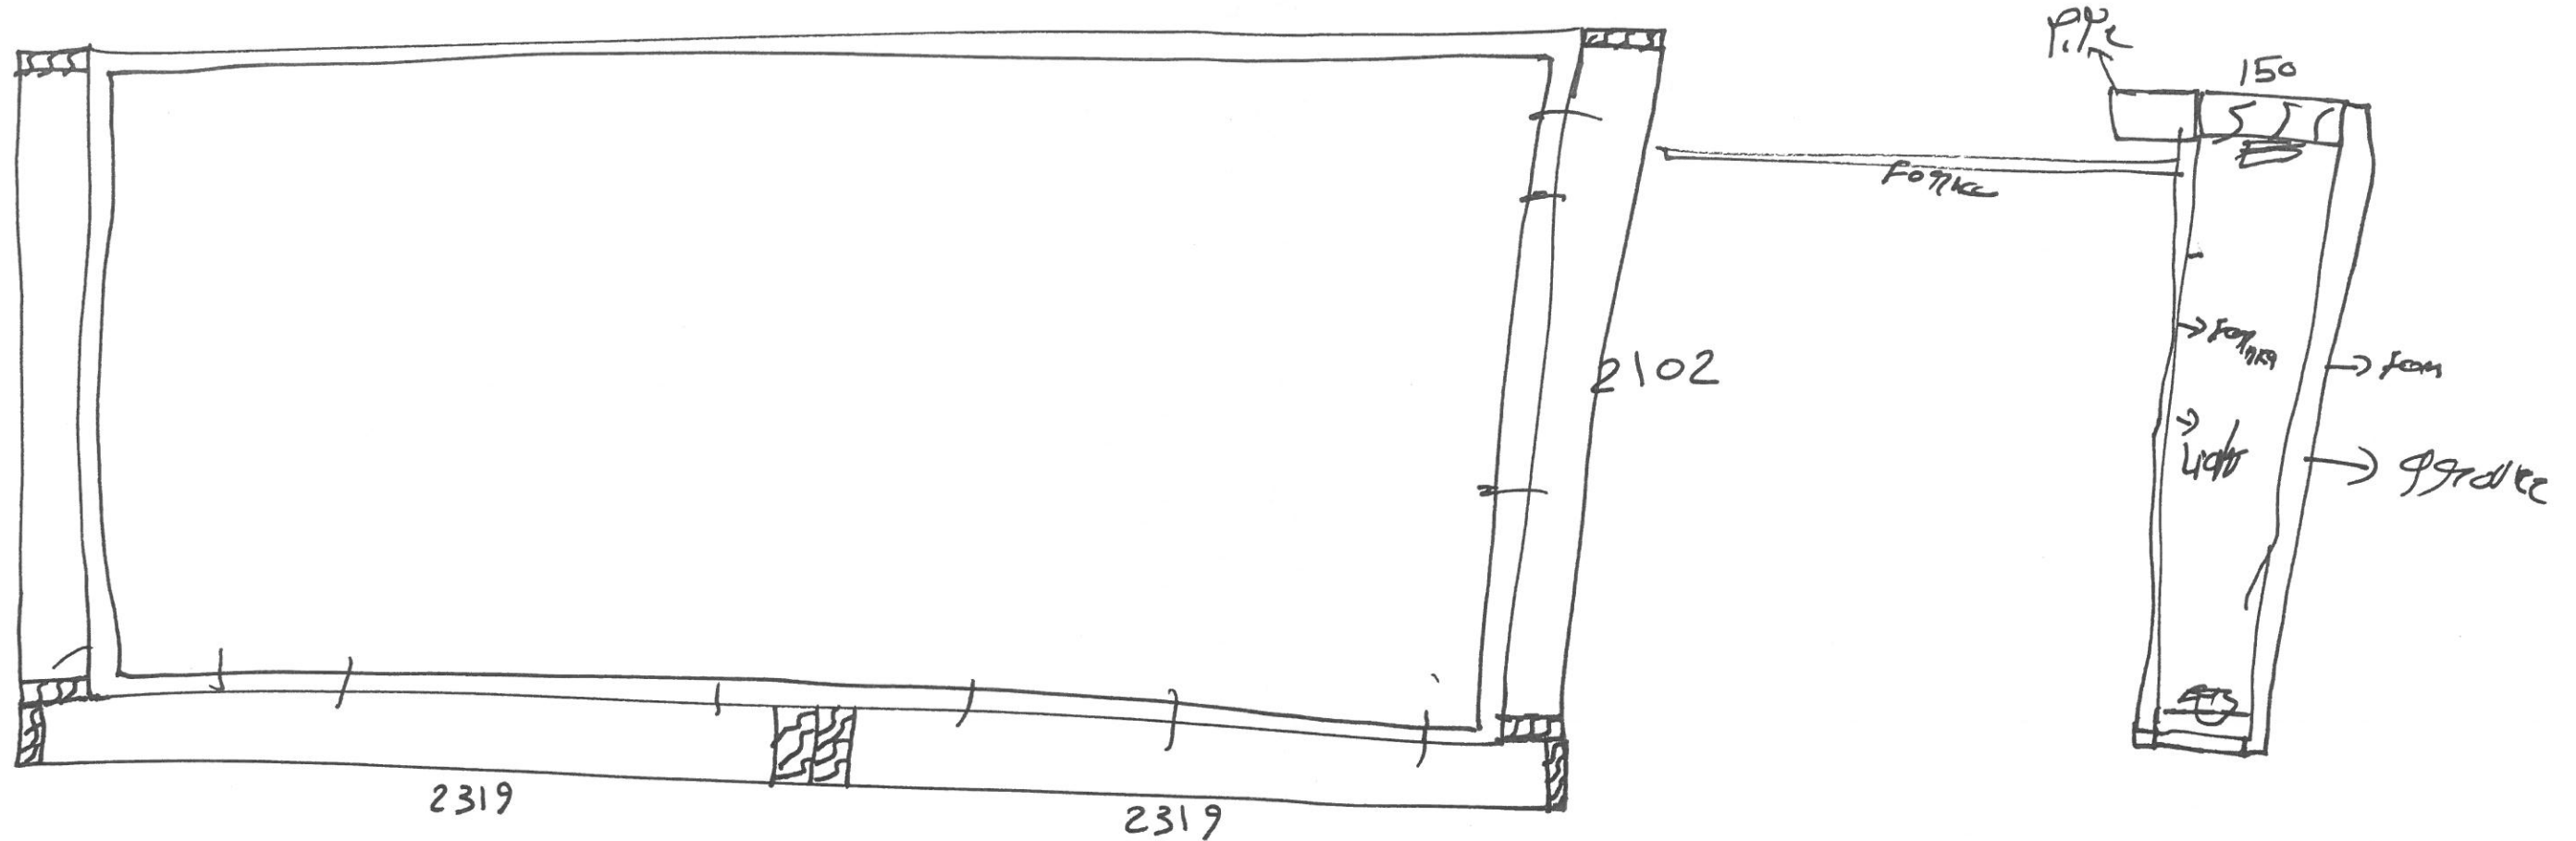

4759

1. ~~2154~~ X 150 X 30 ⇒ 8 pcs Australia wood side
2. 2040 X 150 X 30 ⇒ 4 pcs Australia wood Top+Bottom
- ~~3. 2259 X 150 X 30 ⇒ 4 pcs Australia wood Top+Bottom~~
3. 2259 X 150 X 30 ⇒ 4 pcs Australia wood Top+Bottom
4. 2258 X 2160 X 6 ⇒ 2 pcs side panel out
5. 2114 X 2160 X 6 ⇒ 2 pcs side panel in
6. 2385 X 2160 X 6 ⇒ 2 pcs Front panel out
7. 2229 X 2160 X 6 ⇒ 2 pcs Front panel in