

1. $1800 \times 125 \times 18 \Rightarrow 2 \text{ pcs panel}$

2. $1800 \times 240 \times 18 \Rightarrow 2 \text{ pcs panel}$

3. $1800 \times 350 \times 18 \Rightarrow 1 \text{ pc panel}$

4. $1800 \times 10 \times 16 \Rightarrow 6 \text{ pcs Wood Form groove}$

Mdf

Black


~~Formica~~

1. $450 \times 240 \times 18 \Rightarrow 2 \text{ pcs Front}$

2. $450 \times 70 \times 18 \Rightarrow 4 \text{ pcs side}$

3. $240 \times 70 \times 18 \Rightarrow 4 \text{ pcs Top+Bottom}$

~~Formica~~

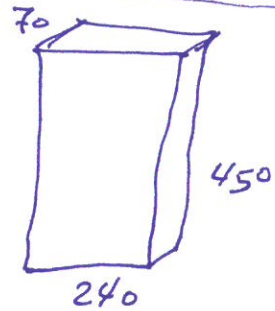


1. $450 \times 350 \times 18 \Rightarrow 1 \text{ pc Front}$

2. $450 \times 70 \times 18 \Rightarrow 2 \text{ pcs side}$

3. $350 \times 70 \times 18 \Rightarrow 2 \text{ pcs Top+Bottom}$

~~Formica~~

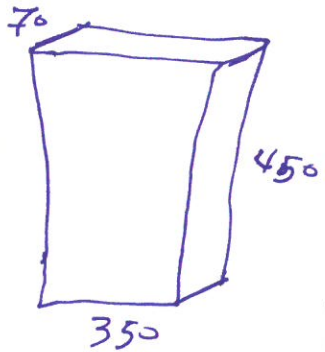


1. $500 \times 330 \times 18 \Rightarrow 2 \text{ pcs side}$

2. $1084 \times 330 \times 18 \Rightarrow 2 \text{ pcs Top+Bottom}$

~~3. $500 \times 1120 \times 18 \Rightarrow$~~

~~3. $500 \times 1120 \times 18 \Rightarrow$~~

3. $1120 \times 500 \times 18 \Rightarrow 1 \text{ pc Door}$

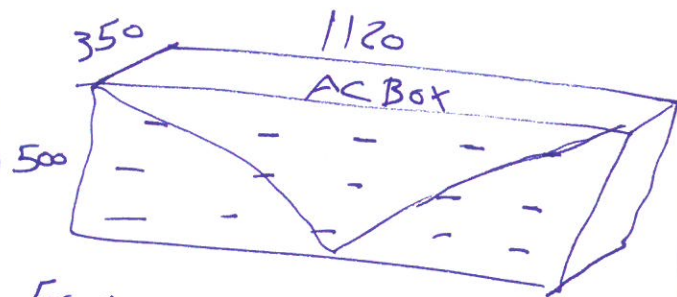

~~Formica~~

Mai shayi

Female toilet

759/P24-04

Project
MAI SHAYI CAFE
ABUJA.

Owner

Date Description
DSD-V1-ID-30/4/2024 - REV1
DSD-V1-ID-31/5/2024 - REV2

FOR APPROVAL

Project No. : ---
Scale : N/A
Drawn by : OBJ
Checked : OBJ
Cad File : CAD_FILE

Sheet title
MAI SHAYI CAFE
female Toilet
Toilet vanity with display wall cladding and
A/C cladding cover


Dwg No. No.
WS-DS-SD-MS-002 SHEET 2

WOODEN
PANEL WITH VENTS
TO COVER THE A/C
AND DIFFUSER

Indirect
Light
(3000)

Indirect
Light
(3000)

Indirect
Light
(3000)

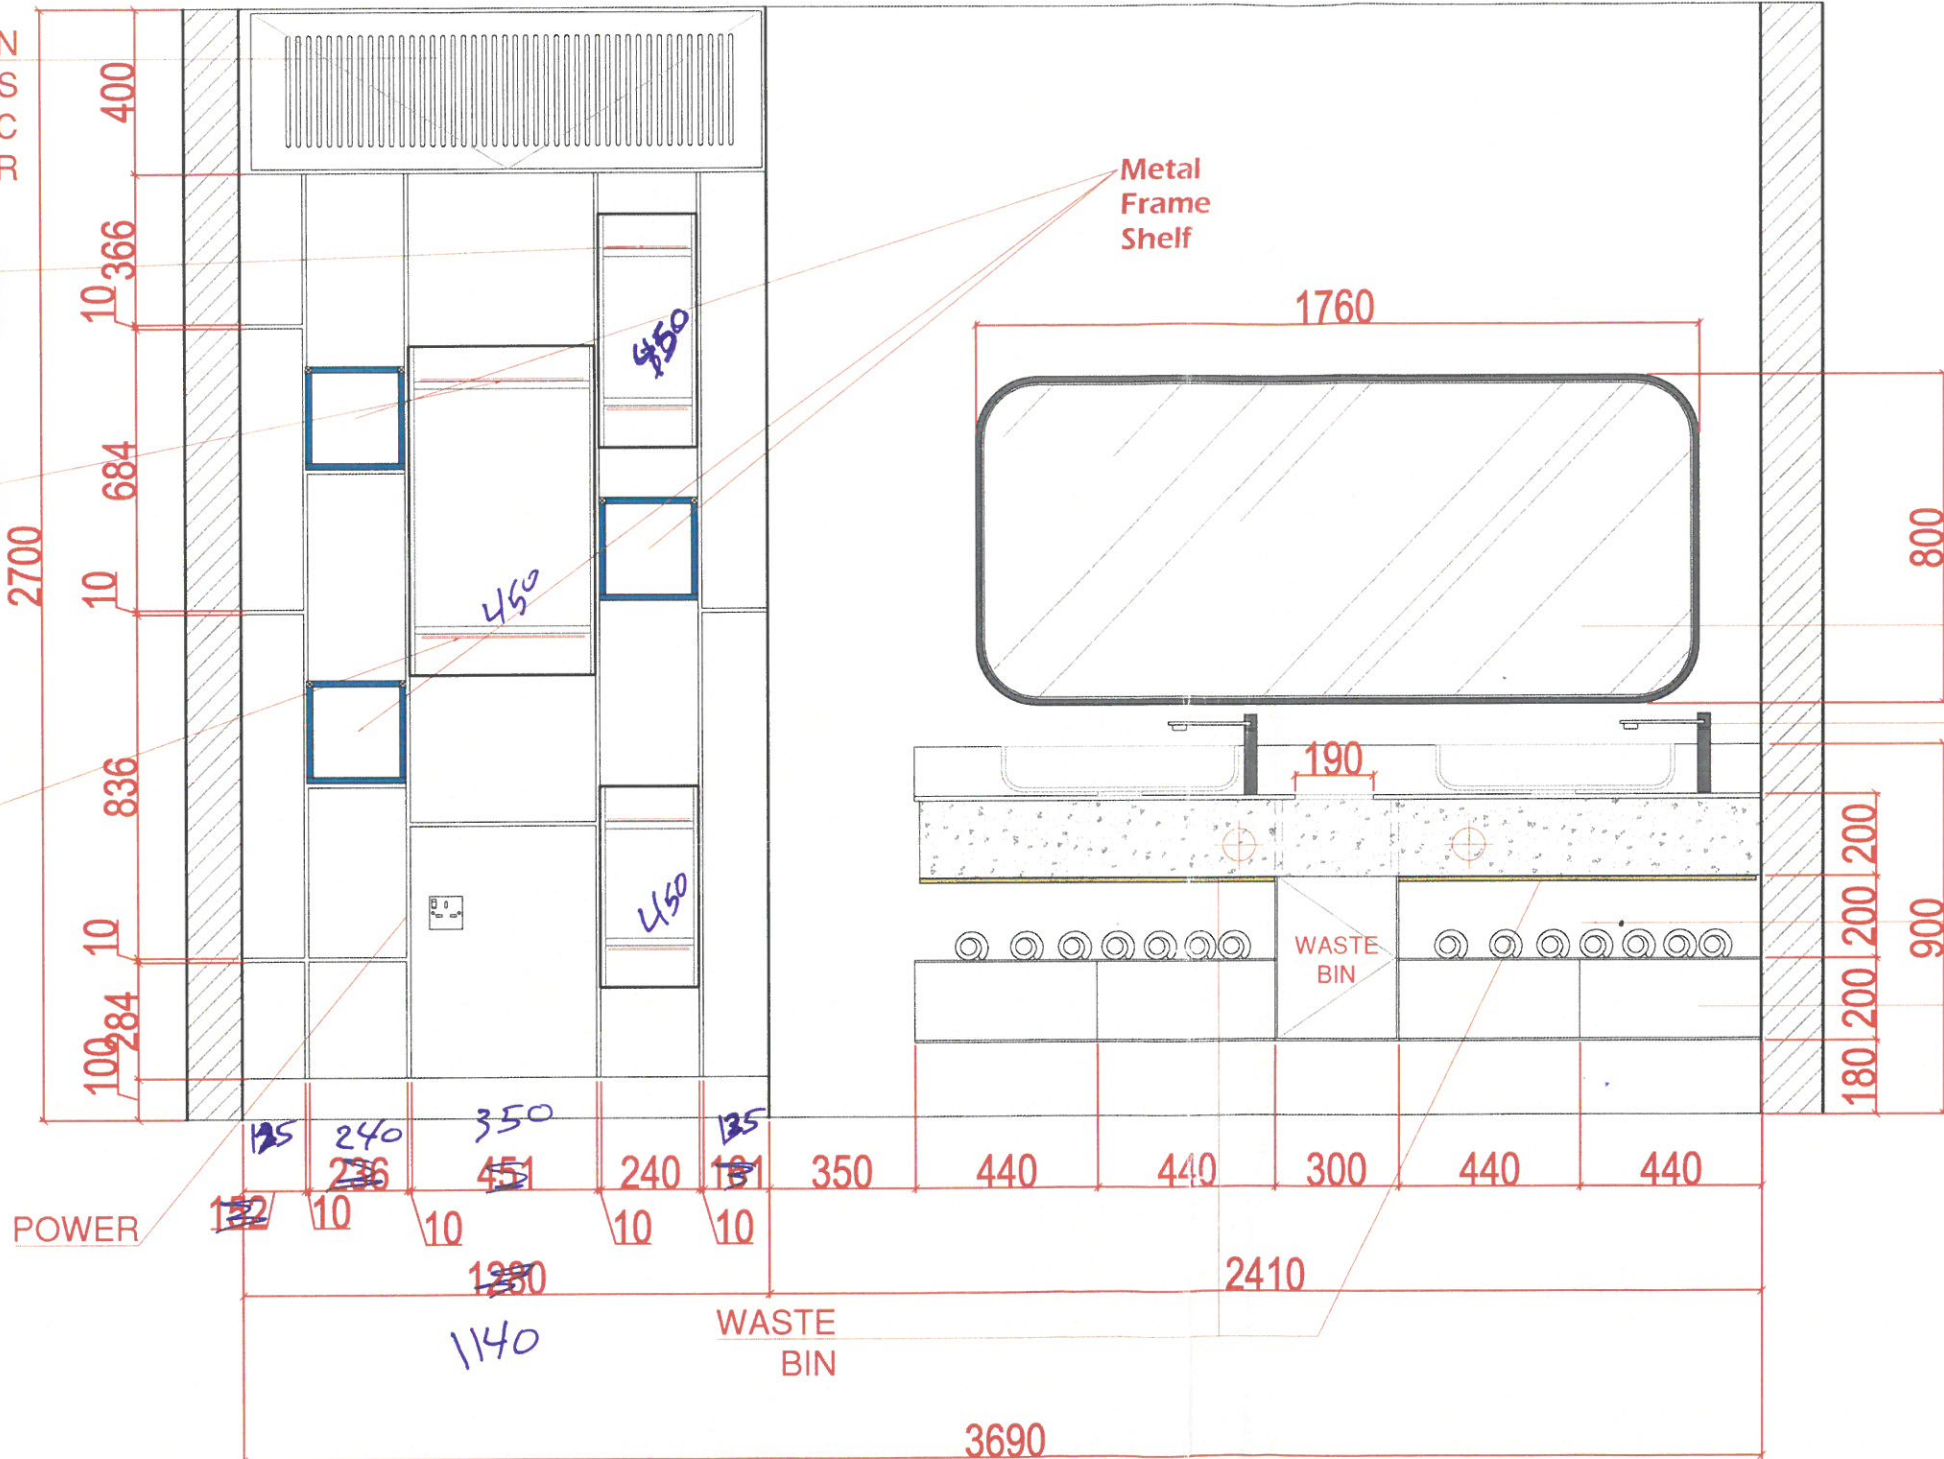

POWER

Metal
Frame
Shelf

MIRROR

BLACK
TAP

OPEN SPACE

DRAWERS

FRONT ELEVATIONS

Female Toilet
TOILET VANITY

